
 


Rose Brook

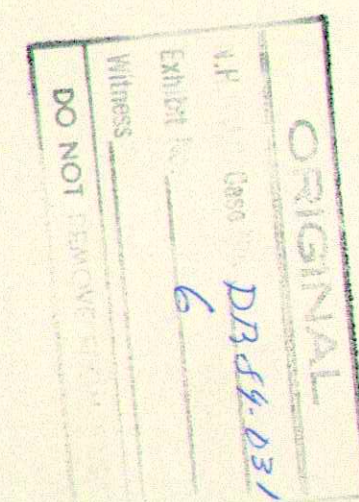

AS-BUILT UTILITIES PLAN
REFERENCE DATE 9/20/00

Bretton Woods Master Plan

Bretton Woods, New Hampshire
for The Satter Companies of New England

CH2 Hill, Bretton Woods
& Associates, Inc.
Master Planning Consultant
The Office of James S. Kennedy
Senior Land Planner
Provan & Lorber
Civil Engineers

Ward & Sibley Inc.
Civil Engineering
Cartographic Associates Inc.
Mapping Consultants